

DISTRICT OF FT. ST. JAMES

WATER DISTRIBUTION SYSTEM RECORD DRAWINGS

CARNELL STREET

MURRAY ROAD

ASH STREET

MORICE AVENUE

SIMON FRASER AVENUE

DEASE AVENUE

OGDEN STREET

DOUGLAS AVENUE

2nd AVENUE WEST*

2nd AVENUE EAST

3rd AVENUE EAST x to murray street

4th AVENUE EAST

5th AVENUE EAST

JUNKER STREET

PINERIDGE ROAD

DOUGLAS AVENUE

STUART DRIVE EAST to 3rd Ave East

STUART DRIVE WEST

KWAH ROAD

2027

OCTOBER 10, 2025

Project Number: 115823082



Consultant

Permit/Seal

Client/Project
DISTRICT OF FT. ST. JAMES

\\n:\115823082\Drawings\2nd Ave West\2nd Ave West.dwg
2025-10-10 10:30:39 AM



ORIGINAL SHEET - A103D

D

C

B

A

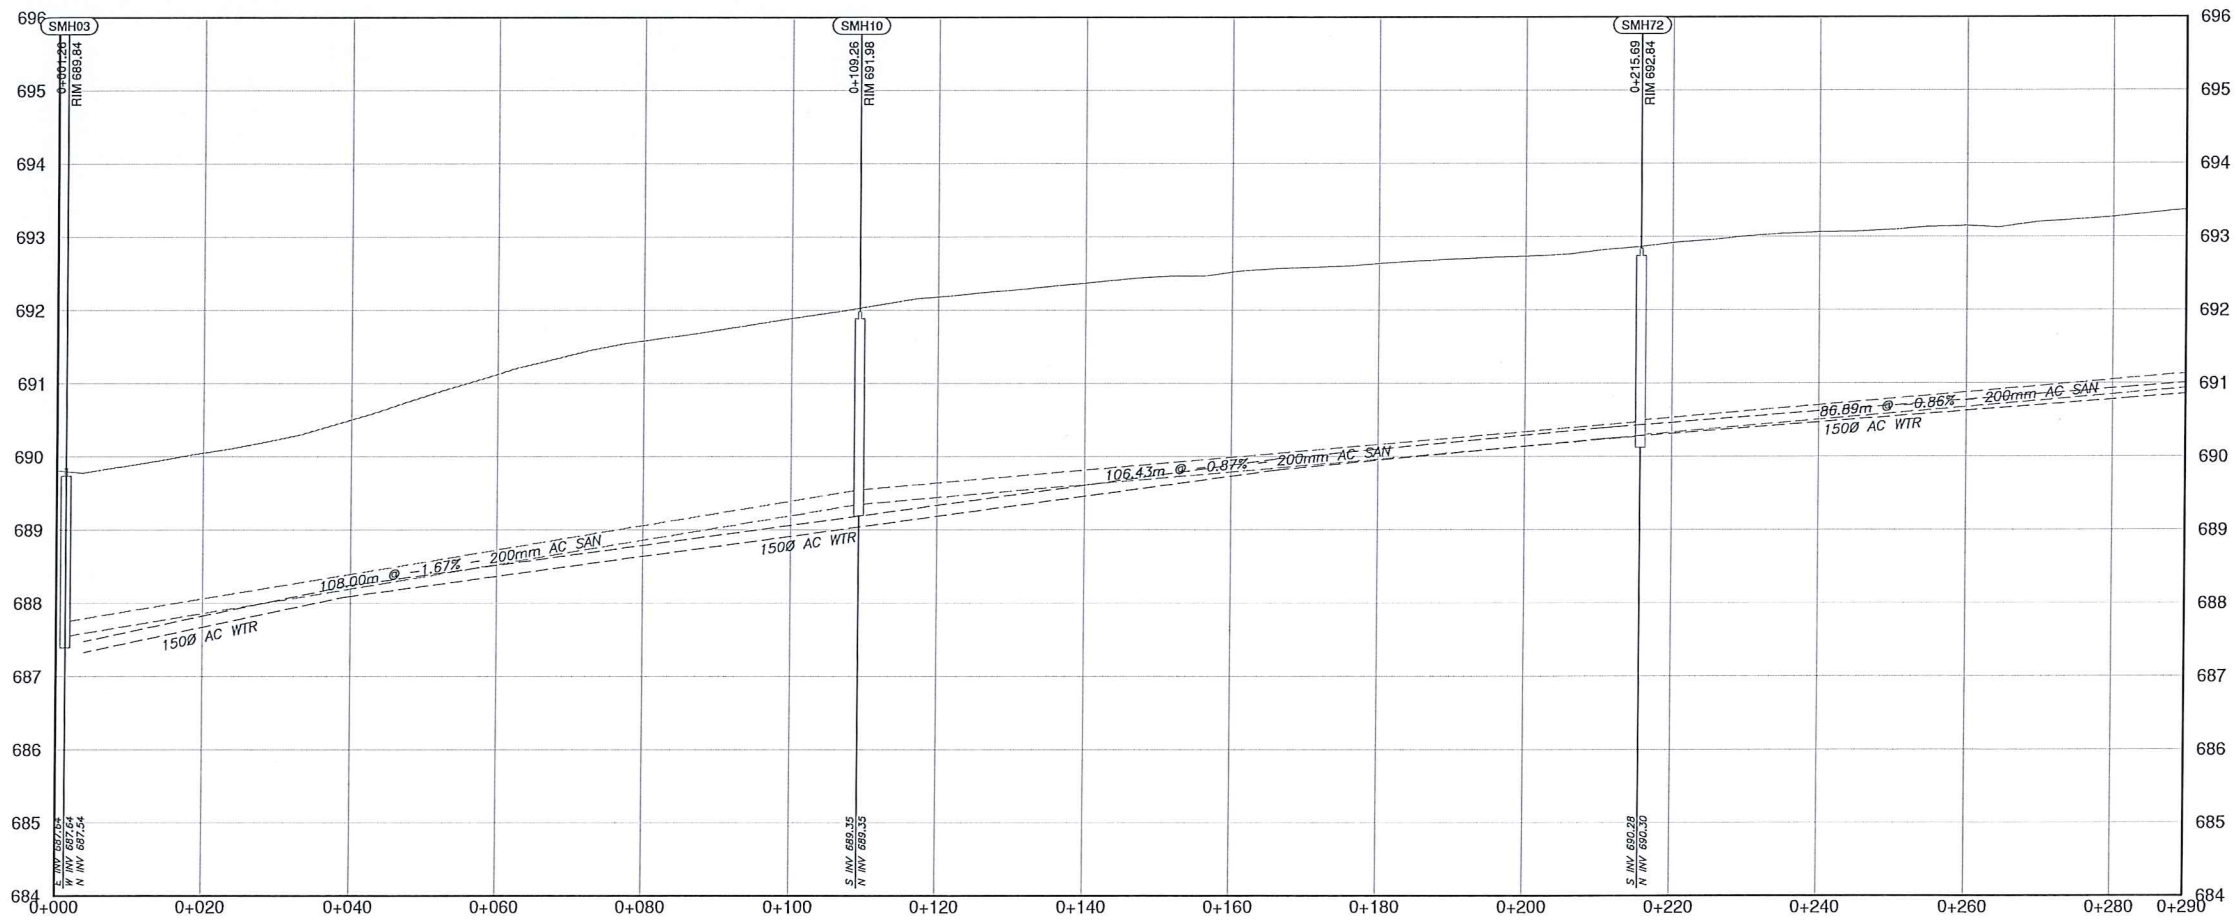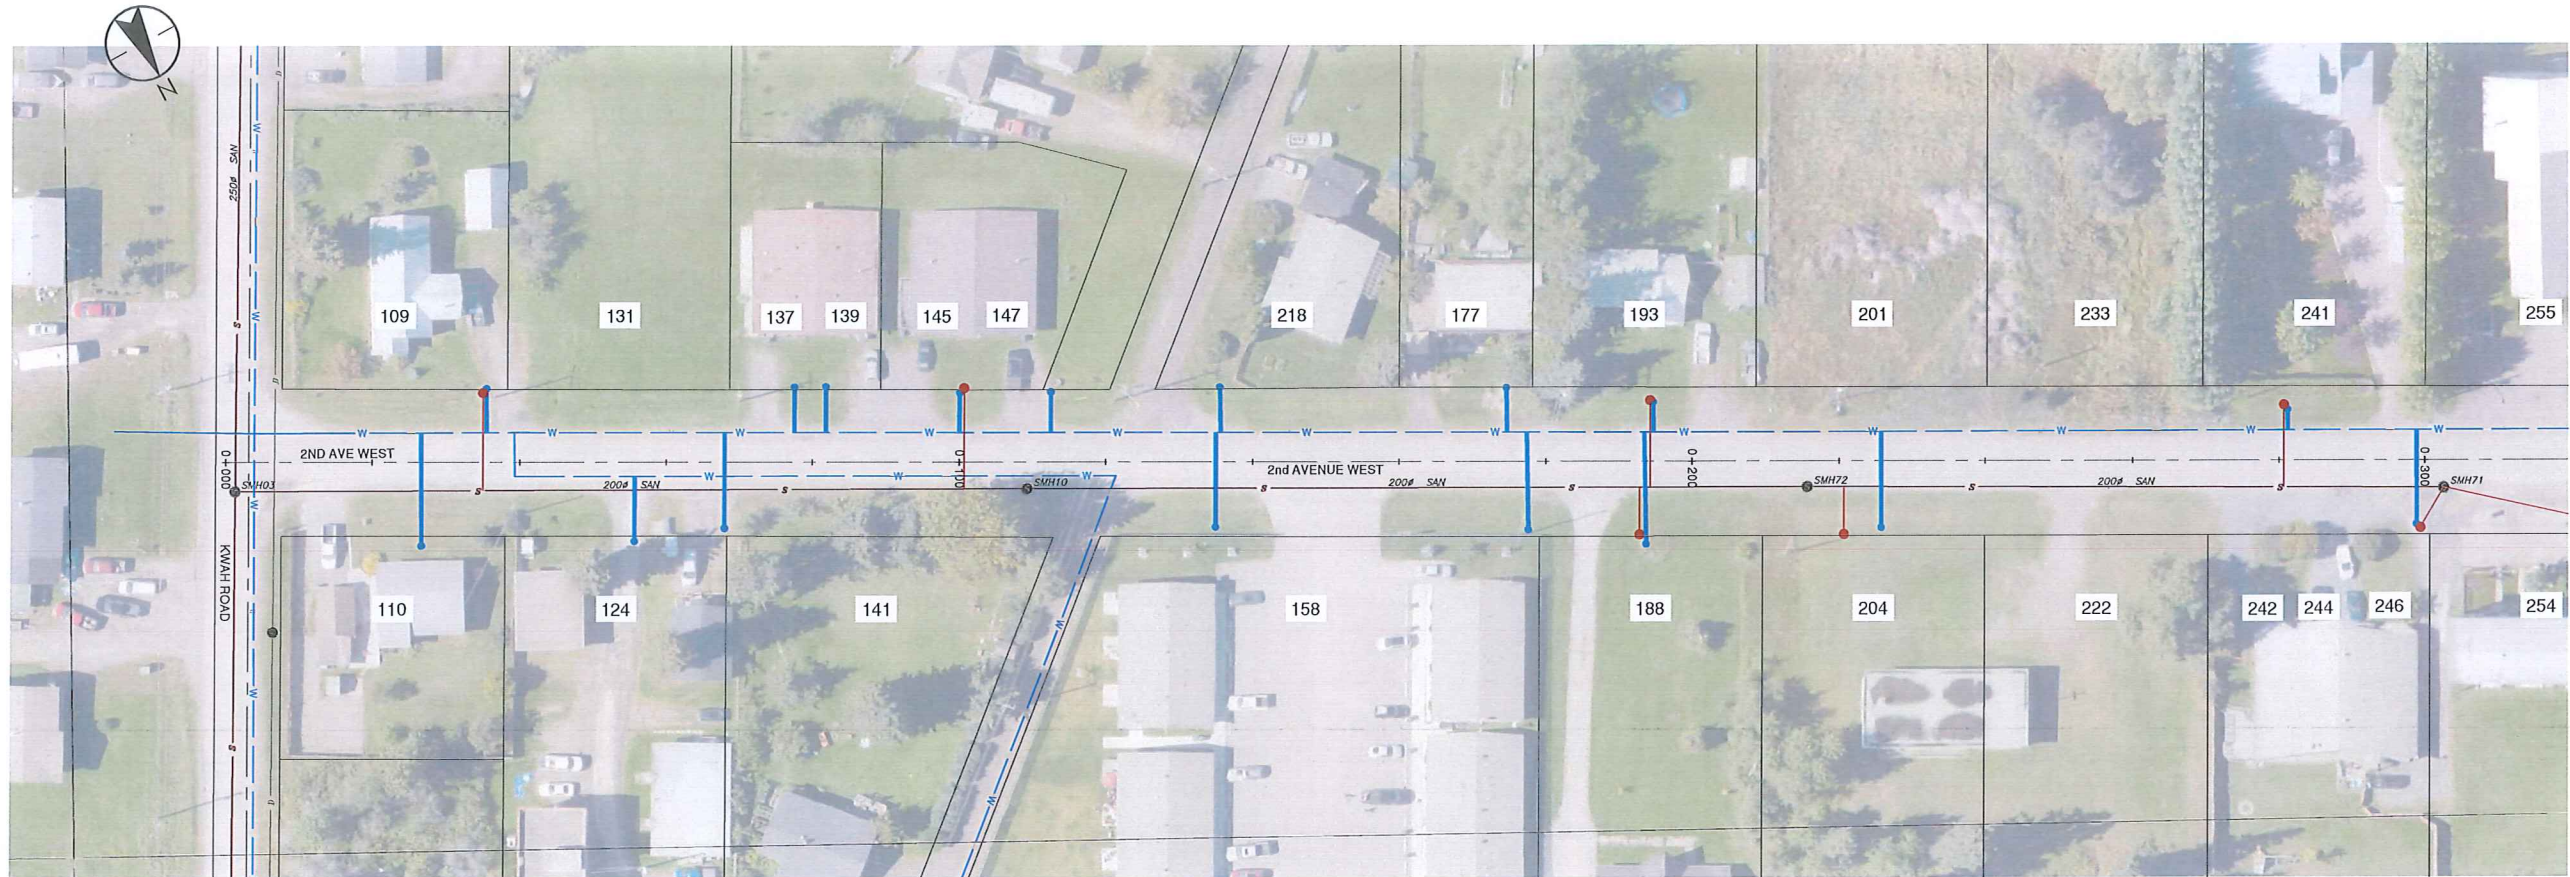

Stantec Consulting Ltd.
2700 17th Avenue SW
Calgary, Alberta T2A 2A7
Tel: (403) 243-2400
www.stantec.com

Consultant

Permit/Seal

**PRELIMINARY
NOT FOR
CONSTRUCTION**

Not for permits, pricing or other official purposes. This document has not been completed or checked and is for general information or comment only.

Client/Project
DISTRICT OF FT. ST. JAMES

WATER DISTRIBUTION
SYSTEM RECORD
DRAWINGS

DISTRICT OF FT. ST. JAMES

Project No.: 115823082

File Name: 2ND AVE WEST

Scale: 1:500

KS	KS	SB	2025-10-10
Dwn.	Dgn.	Chd.	YYYYMMDD

Title
2nd AVE WEST -
SERVICE
CONNECTION

Revision:0 Sheet: - of -

Drawing No.

C115

\\s11\20230823\115823082_2nd_ave_east\project\2nd_ave_east.dwg
2025.10.10 2:25:48 PM



ORIGINAL SHEET - A1010

D

C

B

A

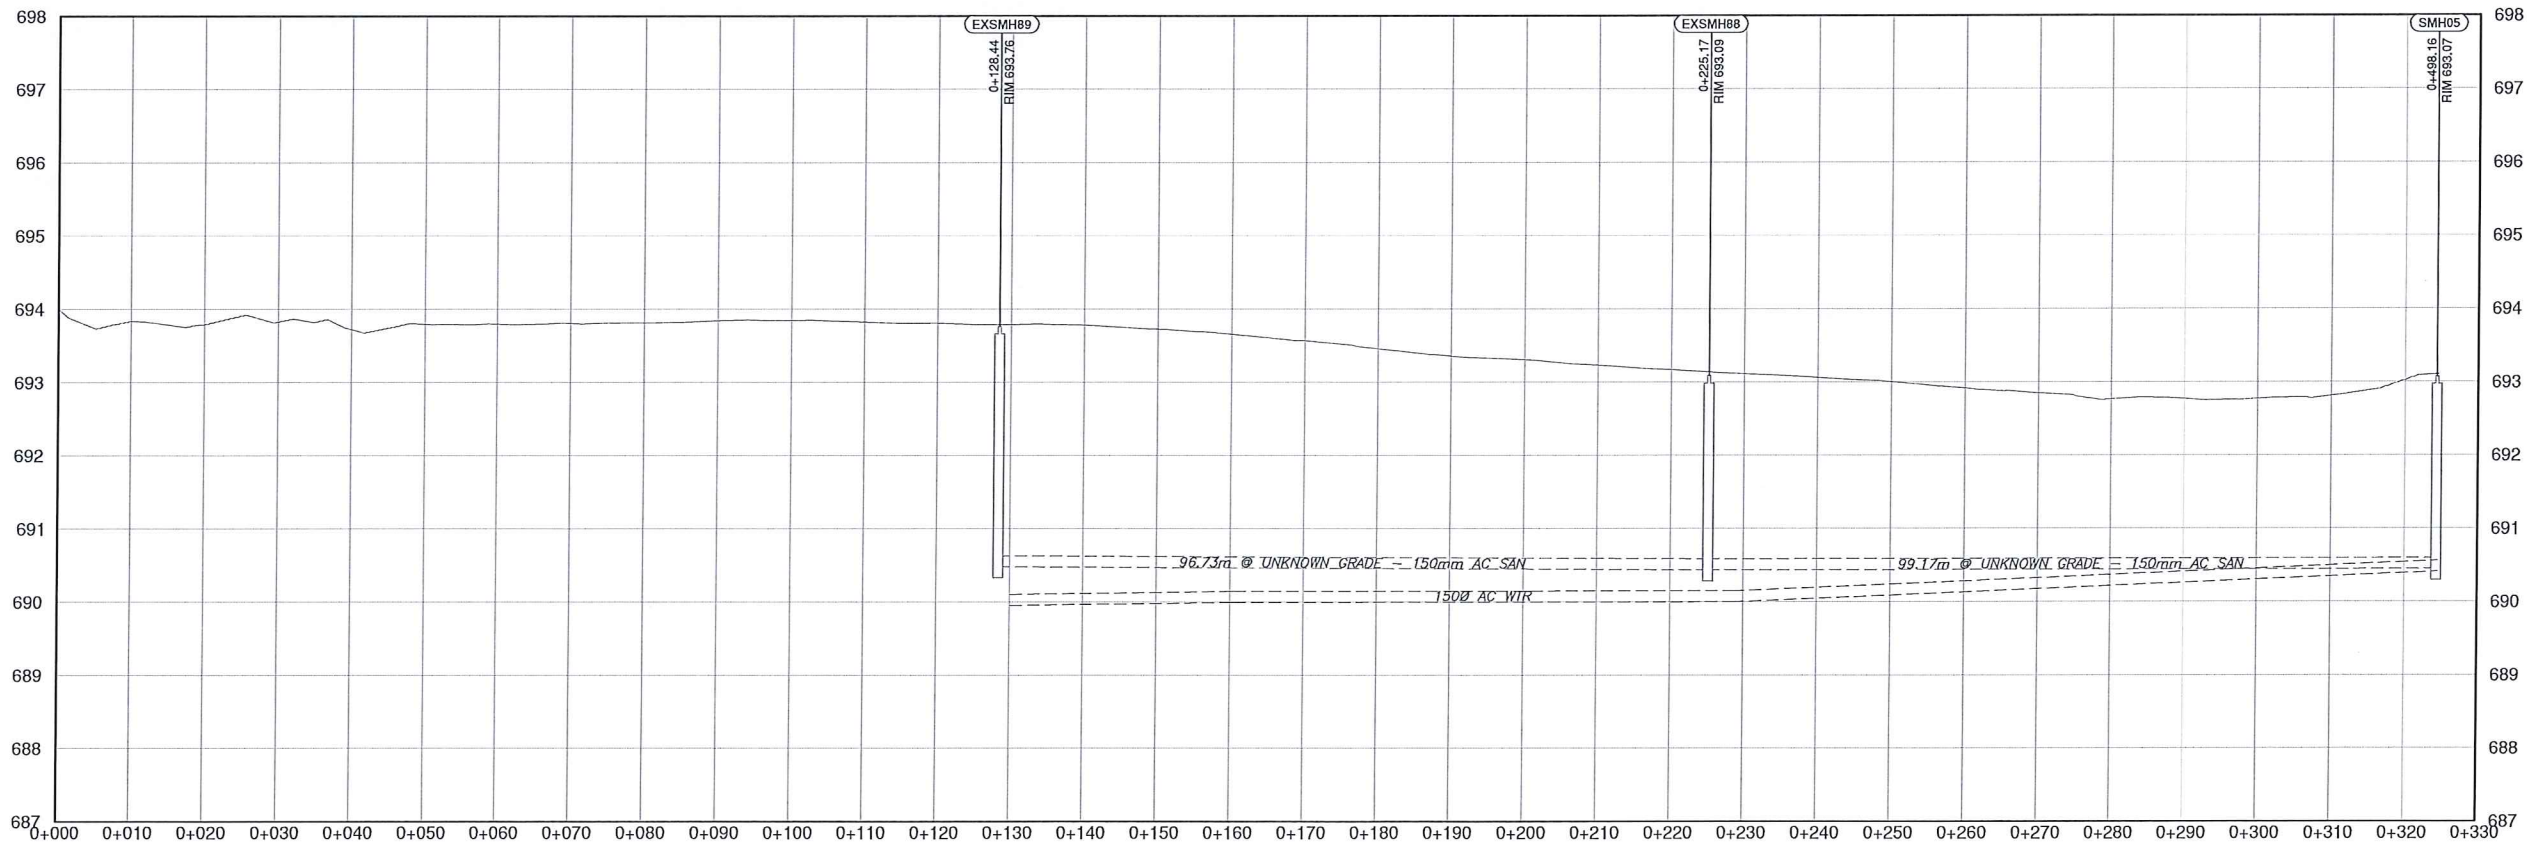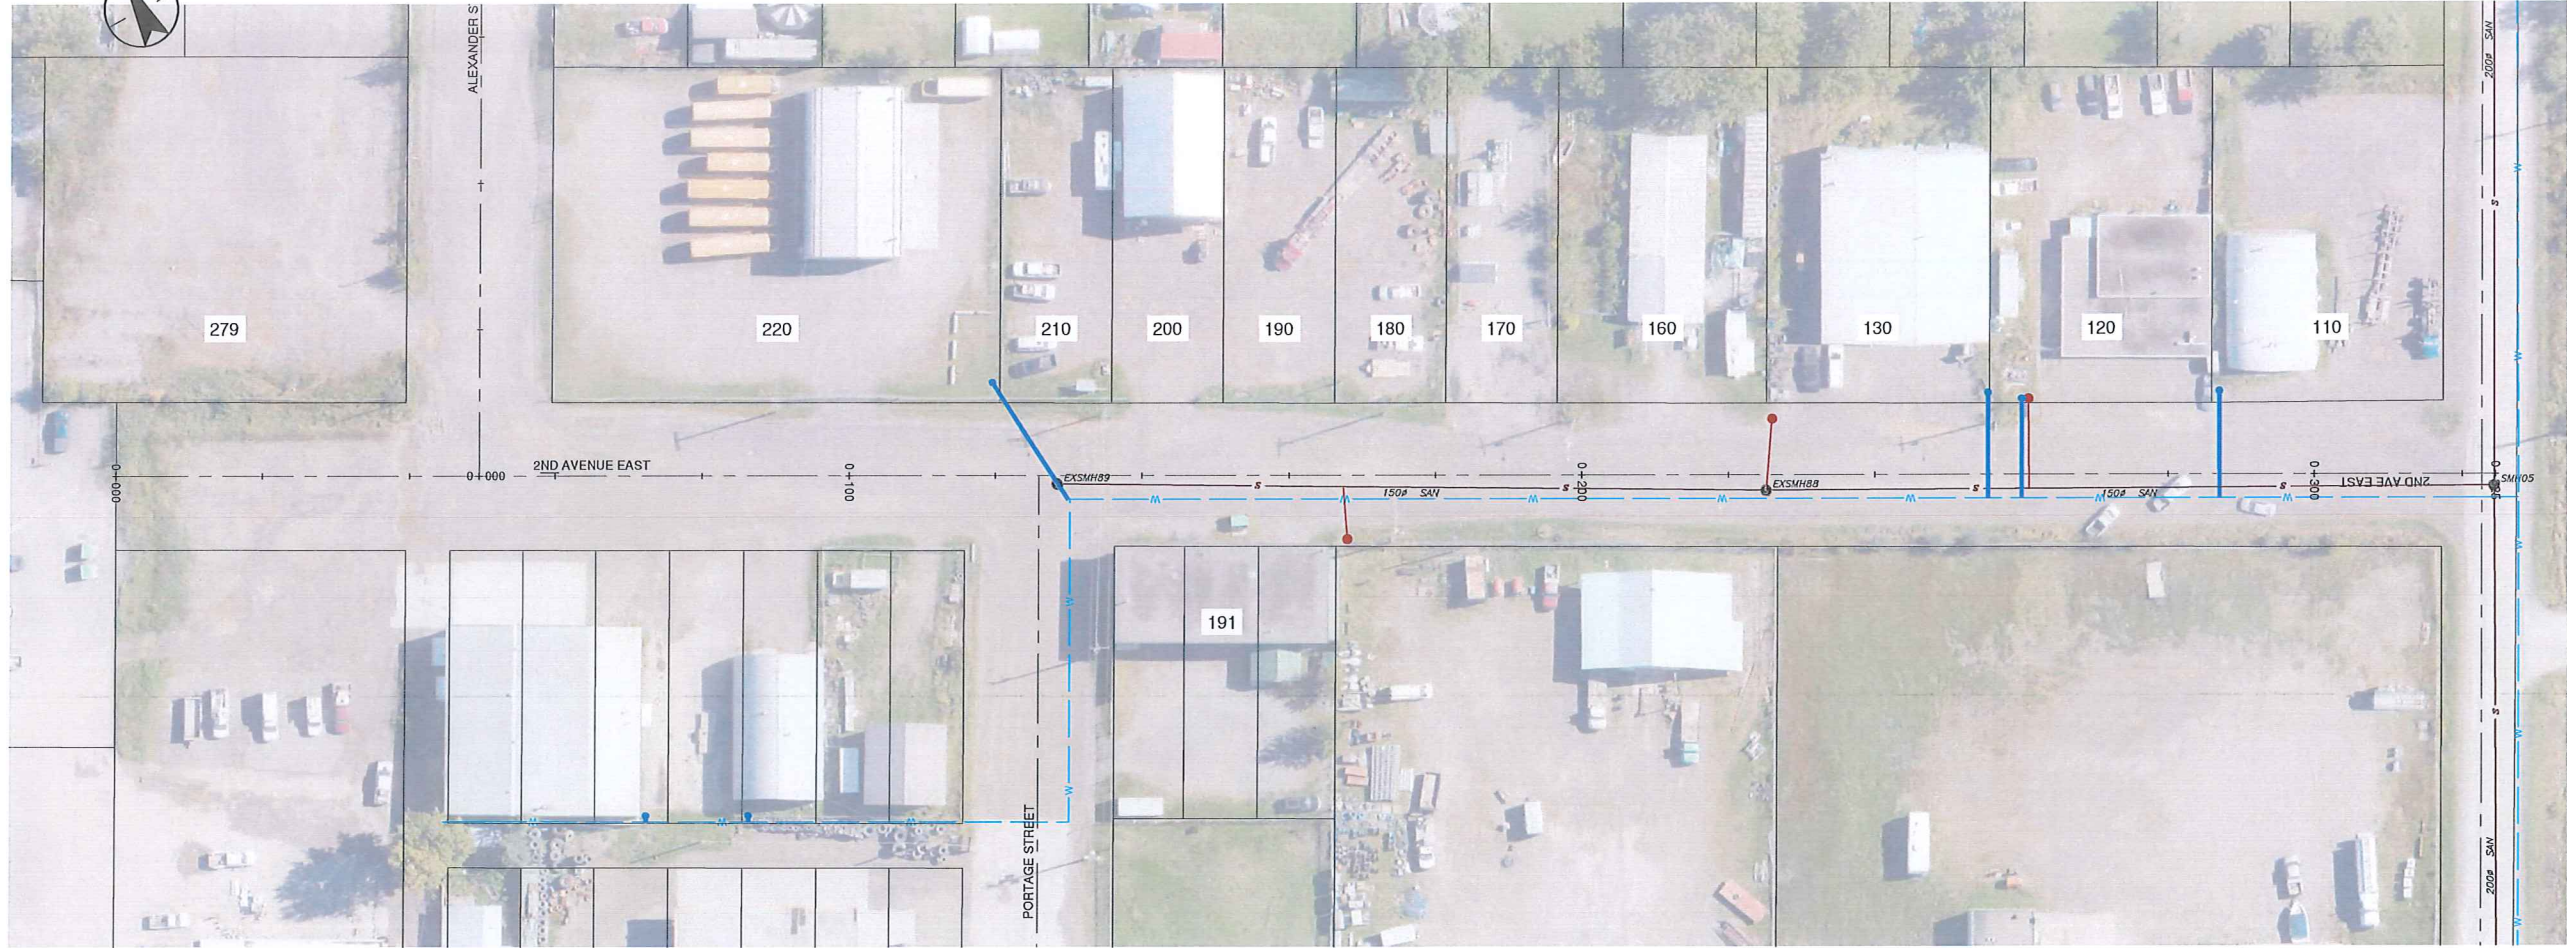

Stantec Consulting Ltd.
445 - 107 Main Street
Winnipeg, Manitoba R2L 2A7
Tel: (204) 465-2400
www.stantec.com

The Contractor shall verify and be responsible for all dimensions. DO NOT scale the drawing. Any errors or omissions shall be reported to Stantec without delay. This drawing is for informational purposes only and is not to be used for any purpose other than that authorized by Stantec. It is void if not used for its intended purpose.

Consultant

Revision	By	Appd	YTY:AM:DD

FOR DECISION	Issued

Permit/Seal

**PRELIMINARY
NOT FOR
CONSTRUCTION**

Not for permits, pricing or other official purposes. This document has not been completed or checked and is for general information or comment only.

Client/Project
DISTRICT OF FT. ST. JAMES

WATER DISTRIBUTION
SYSTEM RECORD
DRAWINGS

DISTRICT OF FT. ST. JAMES

Project No.: 115823082

File Name: 2ND AVE EAST

Scale: 1:500

KS	KS	SB	2025-10-10
Dwn.	Dsgn.	Chkd.	YTY:AM:DD

Title
2ND AVE EAST -
SERVICE
CONNECTIONS

Revision:0 Sheet: - of -

Drawing No.

C117

U:\115823082\Drawings\3rd Ave\3rd Ave East.dwg
2025-10-10 1:14:14 PM



01/24/11 SHEET - A102D

D

C

B

A

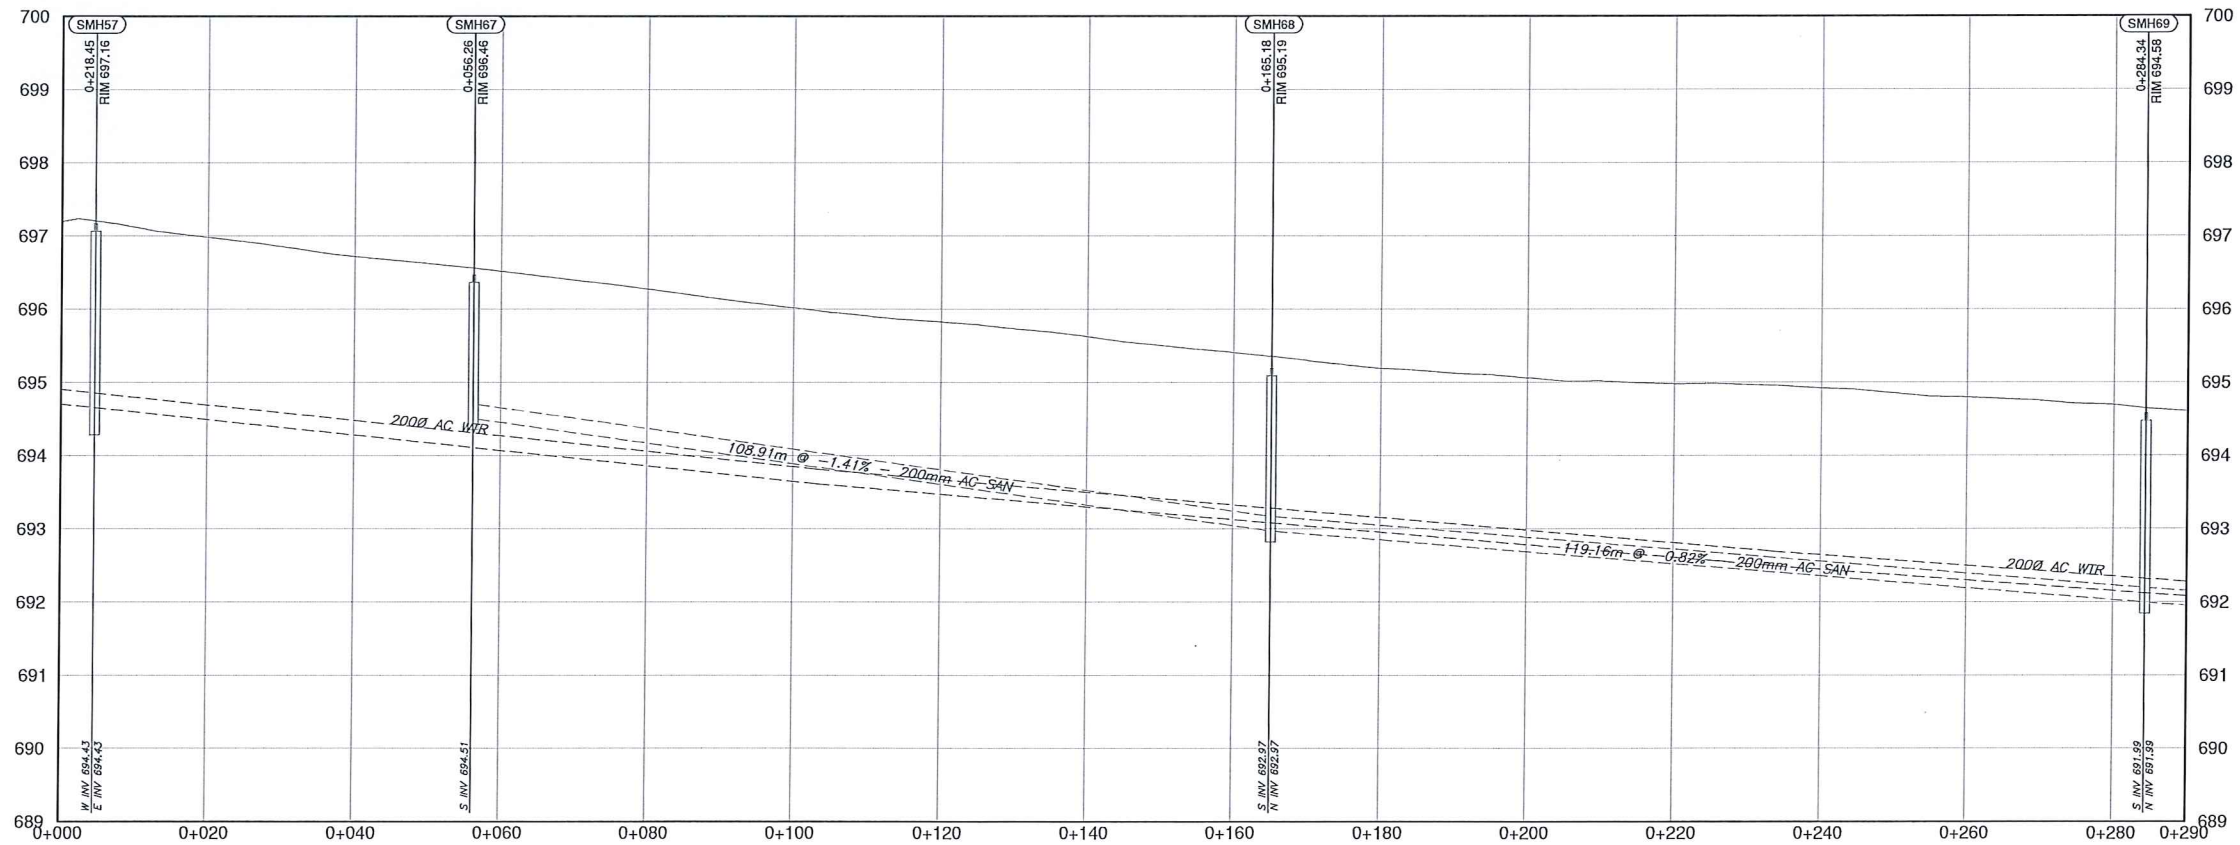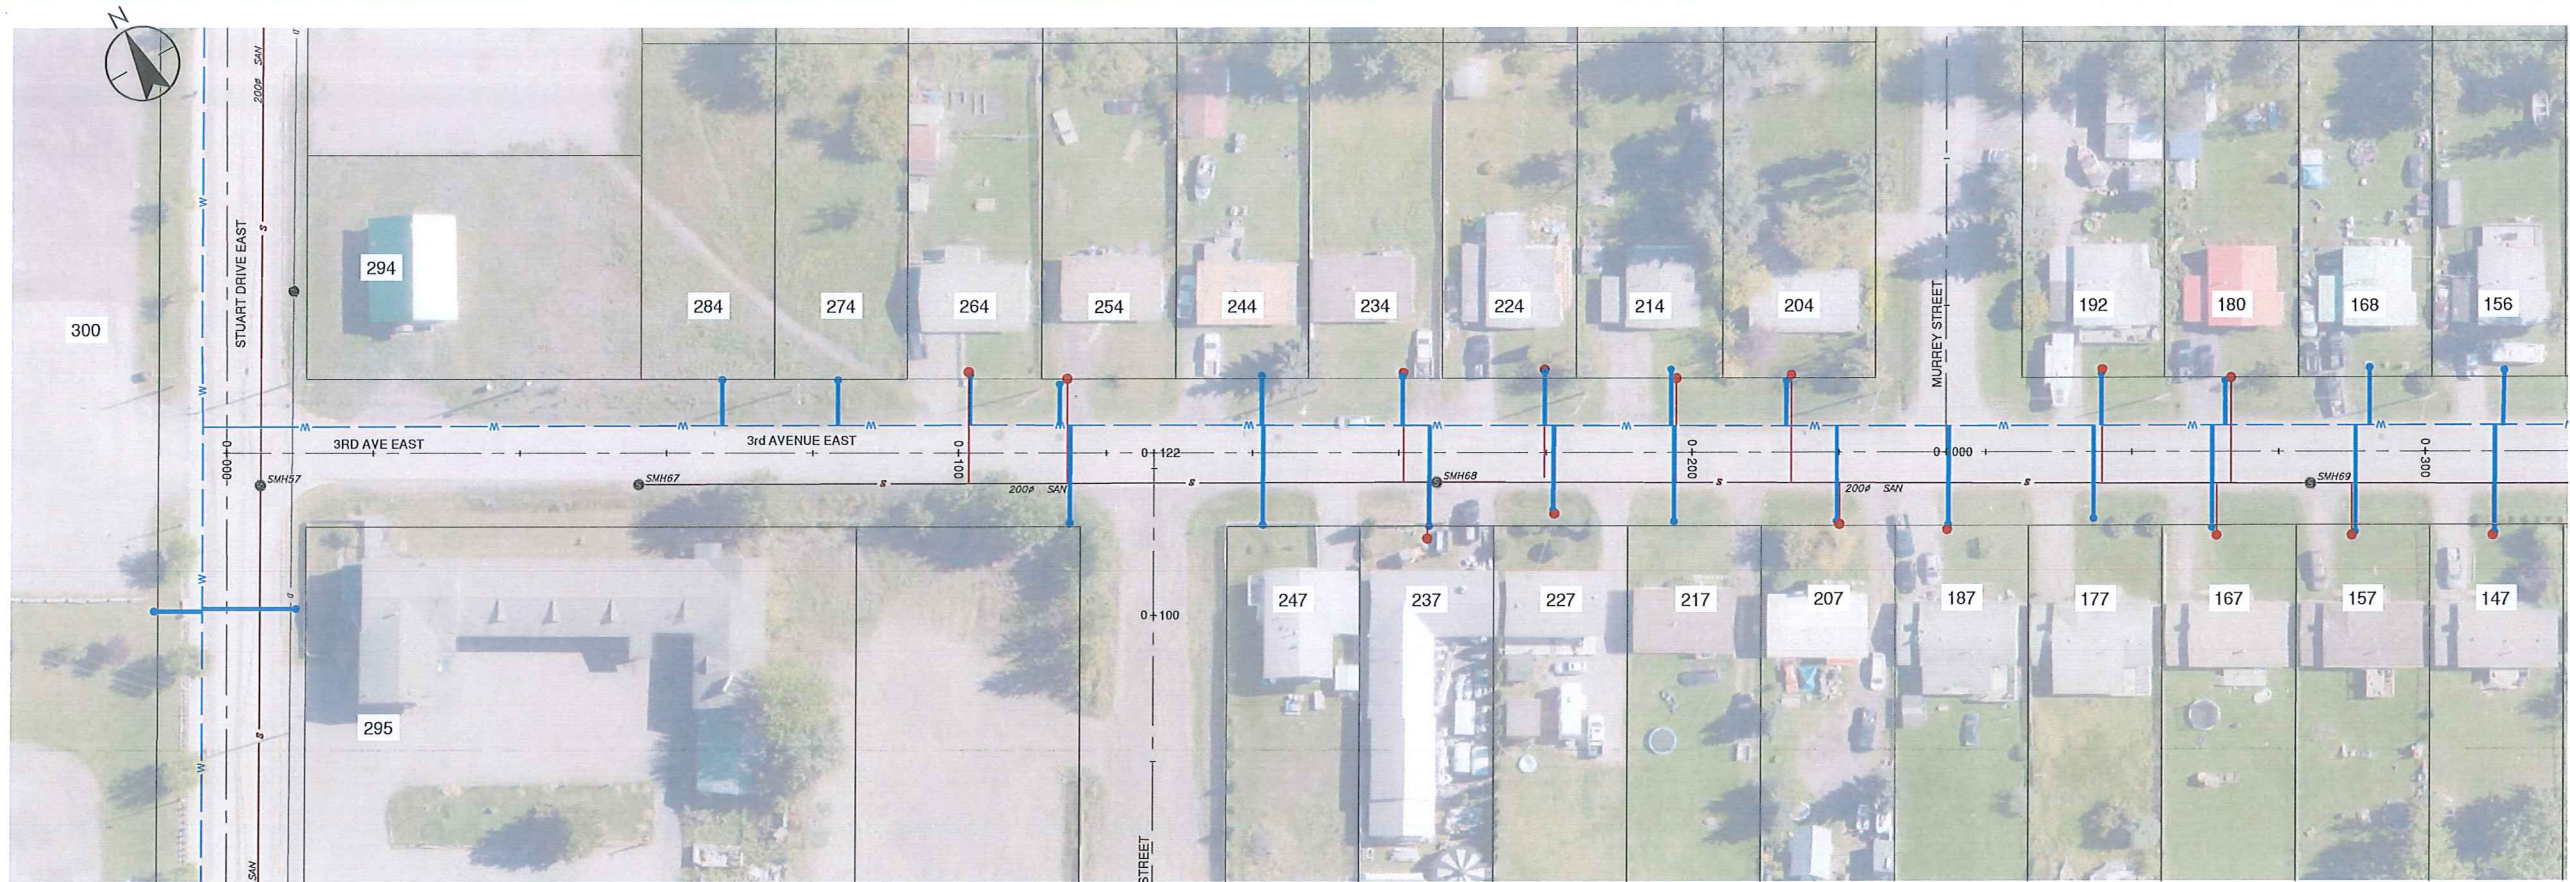

Stantec Consulting Ltd.
202 - 107 Main Street
Winnipeg, Manitoba R2S 1A1
Tel: (204) 581-1111
www.stantec.com

Consultant

Revision	By	Appd	YTT/AM/DD

FOR DISCUSSION	Issued

Permit/Seal

**PRELIMINARY
NOT FOR
CONSTRUCTION**

Not for permits, pricing or other official purposes. This document has not been completed or checked and is for general information or comment only.

Client/Project
DISTRICT OF FT. ST. JAMES

WATER DISTRIBUTION
SYSTEM RECORD
DRAWINGS
DISTRICT OF FT. ST. JAMES

Project No.: 115823082

File Name: 3RD AVE EAST

Scale: 1:500

KS	KS	SB	2025-10-10
Dwn.	Dgn.	Chd.	YTT/AM/DD

Title
**3RD AVE - SERVICE
CONNECTIONS**

Revision:0 Sheet: - of -
Drawing No.

C118

