

DISTRICT OF FT. ST. JAMES

WATER DISTRIBUTION SYSTEM RECORD DRAWINGS

CARNELL STREET

MURRAY ROAD

ASH STREET

MORICE AVENUE

SIMON FRASER AVENUE

DEASE AVENUE

OGDEN STREET

DOUGLAS AVENUE

2nd AVENUE WEST

2nd AVENUE EAST

● 3rd AVENUE EAST From Murray to Kwah ✕

● 4th AVENUE EAST ✕

● 5th AVENUE EAST ✕

JUNKER STREET

● PINERIDGE ROAD ✕

DOUGLAS AVENUE

● STUART DRIVE EAST From 3rd to Pineridge ✕

STUART DRIVE WEST

● KWAH ROAD

2028

OCTOBER 10, 2025

Project Number: 115823082

\\115823082\proj_115823082\dwg\115823082.dwg
2025-10-10 10:30:27 PM



ORIGINAL SHEET - A-100

D

C

B

A

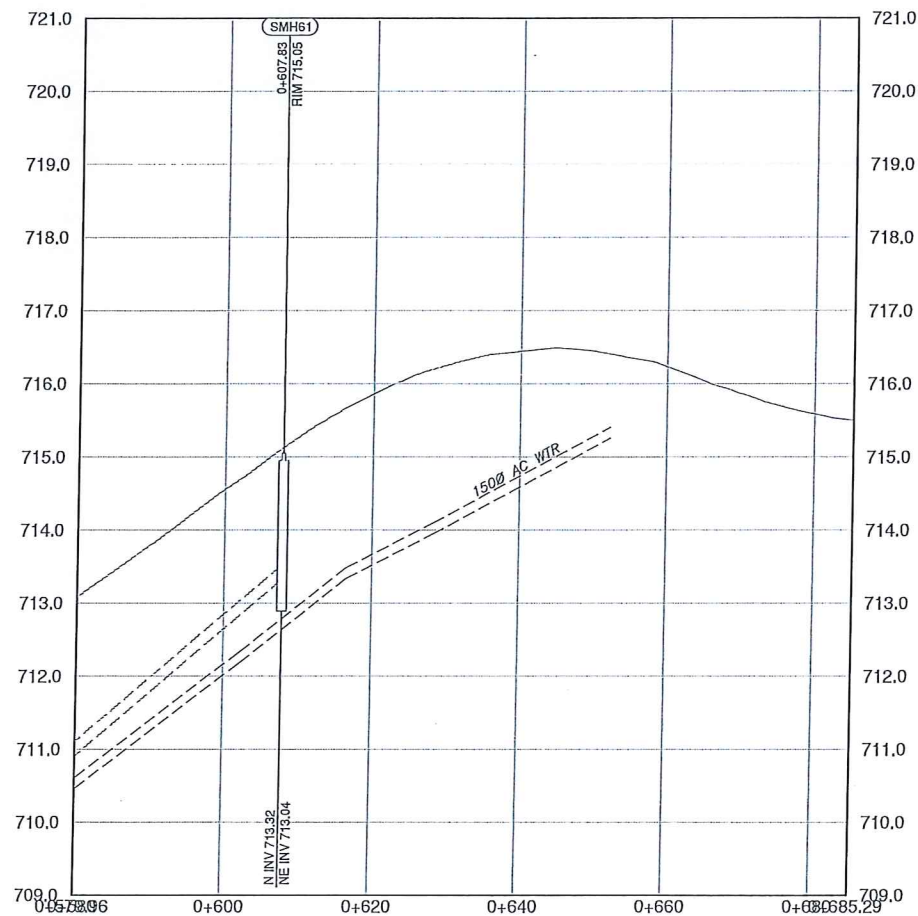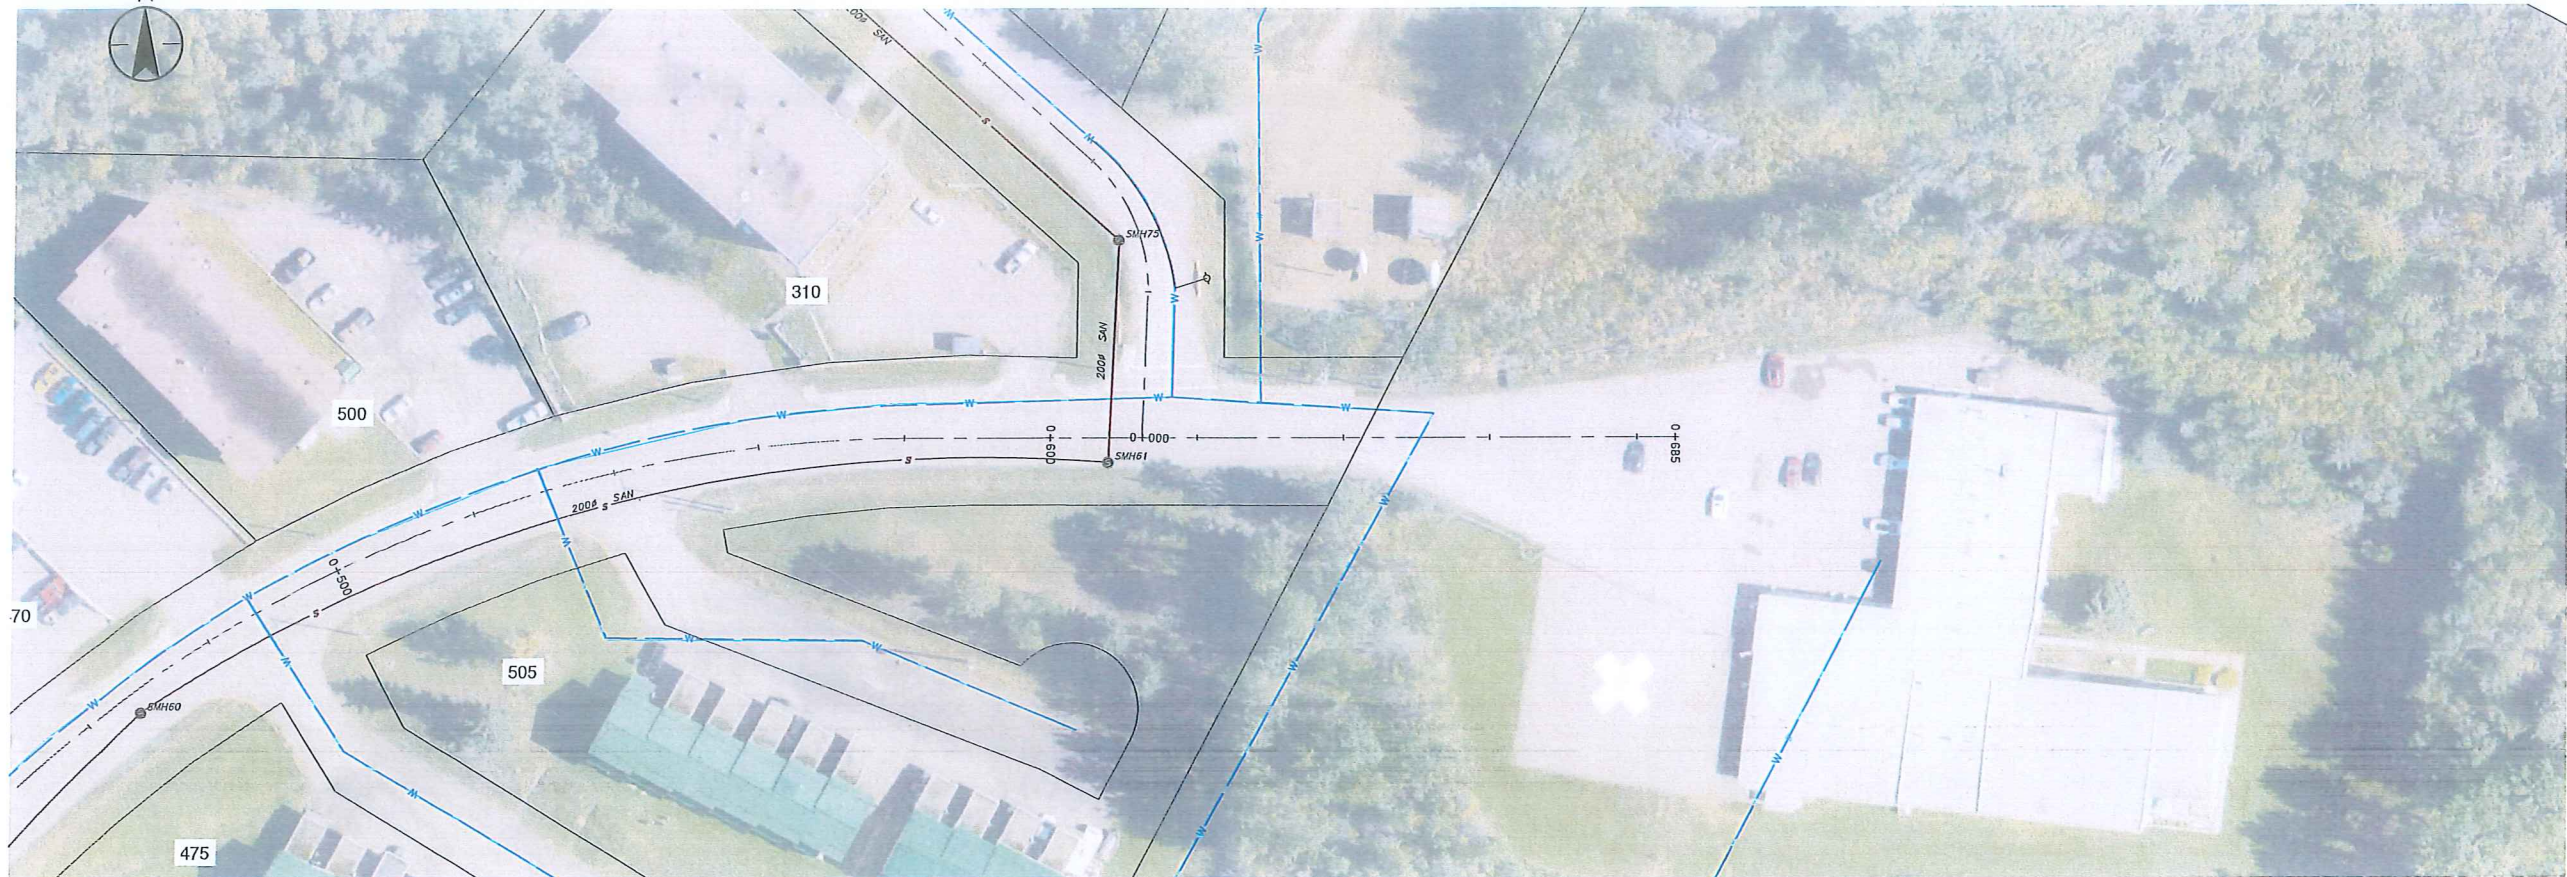

Stantec Consulting Ltd.
202 - 107 Main Street
Whitehorse, Yukon Y1A 2A7
Tel: (867) 663-2400
www.stantec.com

The Contractor shall verify and be responsible for all dimensions. DO NOT scale the drawing. The Contractor shall verify and be responsible for all dimensions. DO NOT scale the drawing. The Contractor shall verify and be responsible for all dimensions. DO NOT scale the drawing.

Consultant

Revision	By	Appd	TTT/AM/DO
1	KS	KS	2025-10-10
2	KS	KS	2025-10-10
3	KS	KS	2025-10-10
4	KS	KS	2025-10-10
5	KS	KS	2025-10-10
6	KS	KS	2025-10-10
7	KS	KS	2025-10-10
8	KS	KS	2025-10-10
9	KS	KS	2025-10-10
10	KS	KS	2025-10-10

Revision	By	Appd	TTT/AM/DO
1	KS	KS	2025-10-10
2	KS	KS	2025-10-10
3	KS	KS	2025-10-10
4	KS	KS	2025-10-10
5	KS	KS	2025-10-10
6	KS	KS	2025-10-10
7	KS	KS	2025-10-10
8	KS	KS	2025-10-10
9	KS	KS	2025-10-10
10	KS	KS	2025-10-10

Permit/Seal

**PRELIMINARY
NOT FOR
CONSTRUCTION**

Not for permits, pricing or other official purposes. This document has not been completed or checked and is for general information or comment only.

Client/Project
DISTRICT OF FT. ST. JAMES

WATER DISTRIBUTION
SYSTEM RECORD
DRAWINGS

DISTRICT OF FT. ST. JAMES

Project No.: 115823082

File Name: STUART DRIVE EAST

Scale: 1:500

Dwn	Dsgn	Chkd	2025-10-10
KS	KS	KS	2025-10-10



Title

STUART DR. EAST -
SERVICE
CONNECTIONS

Revision: 0 Sheet: - of -

Drawing No.

C129

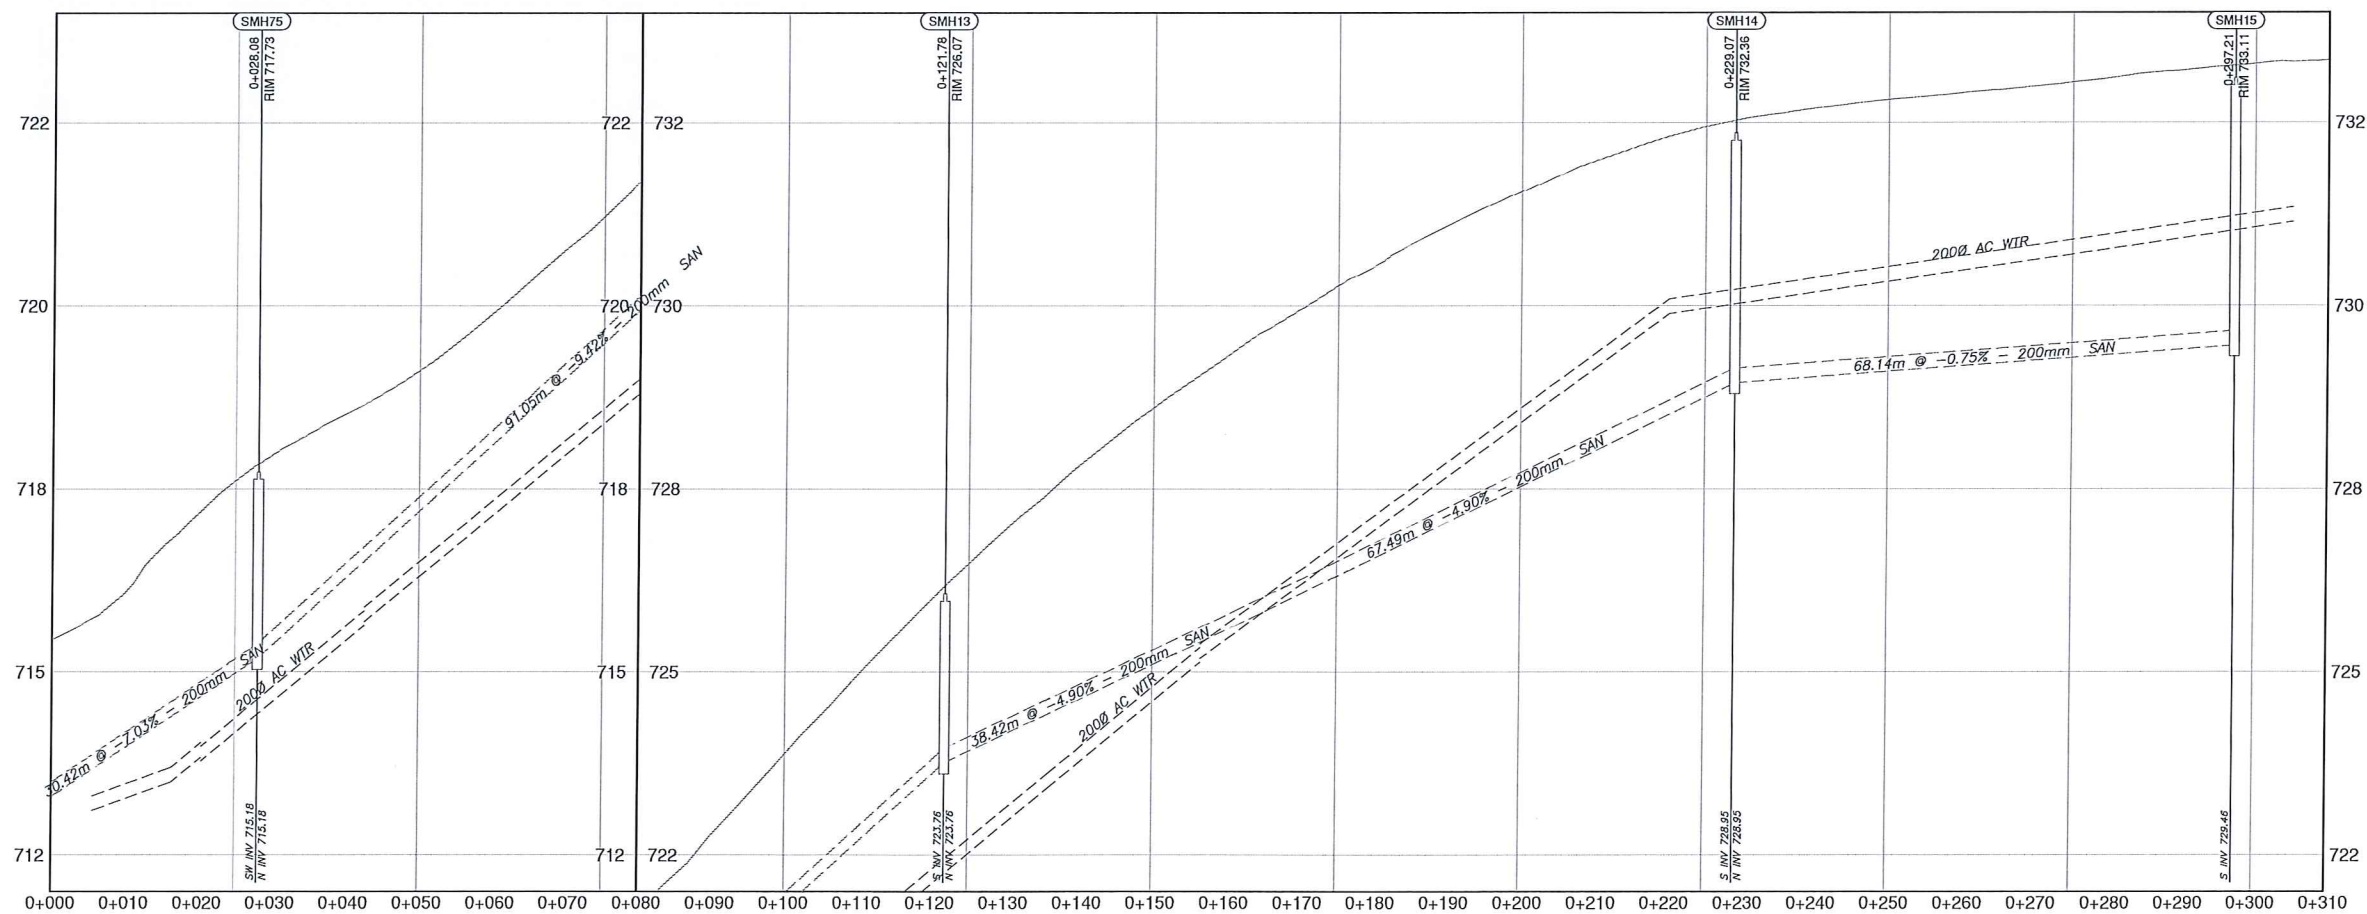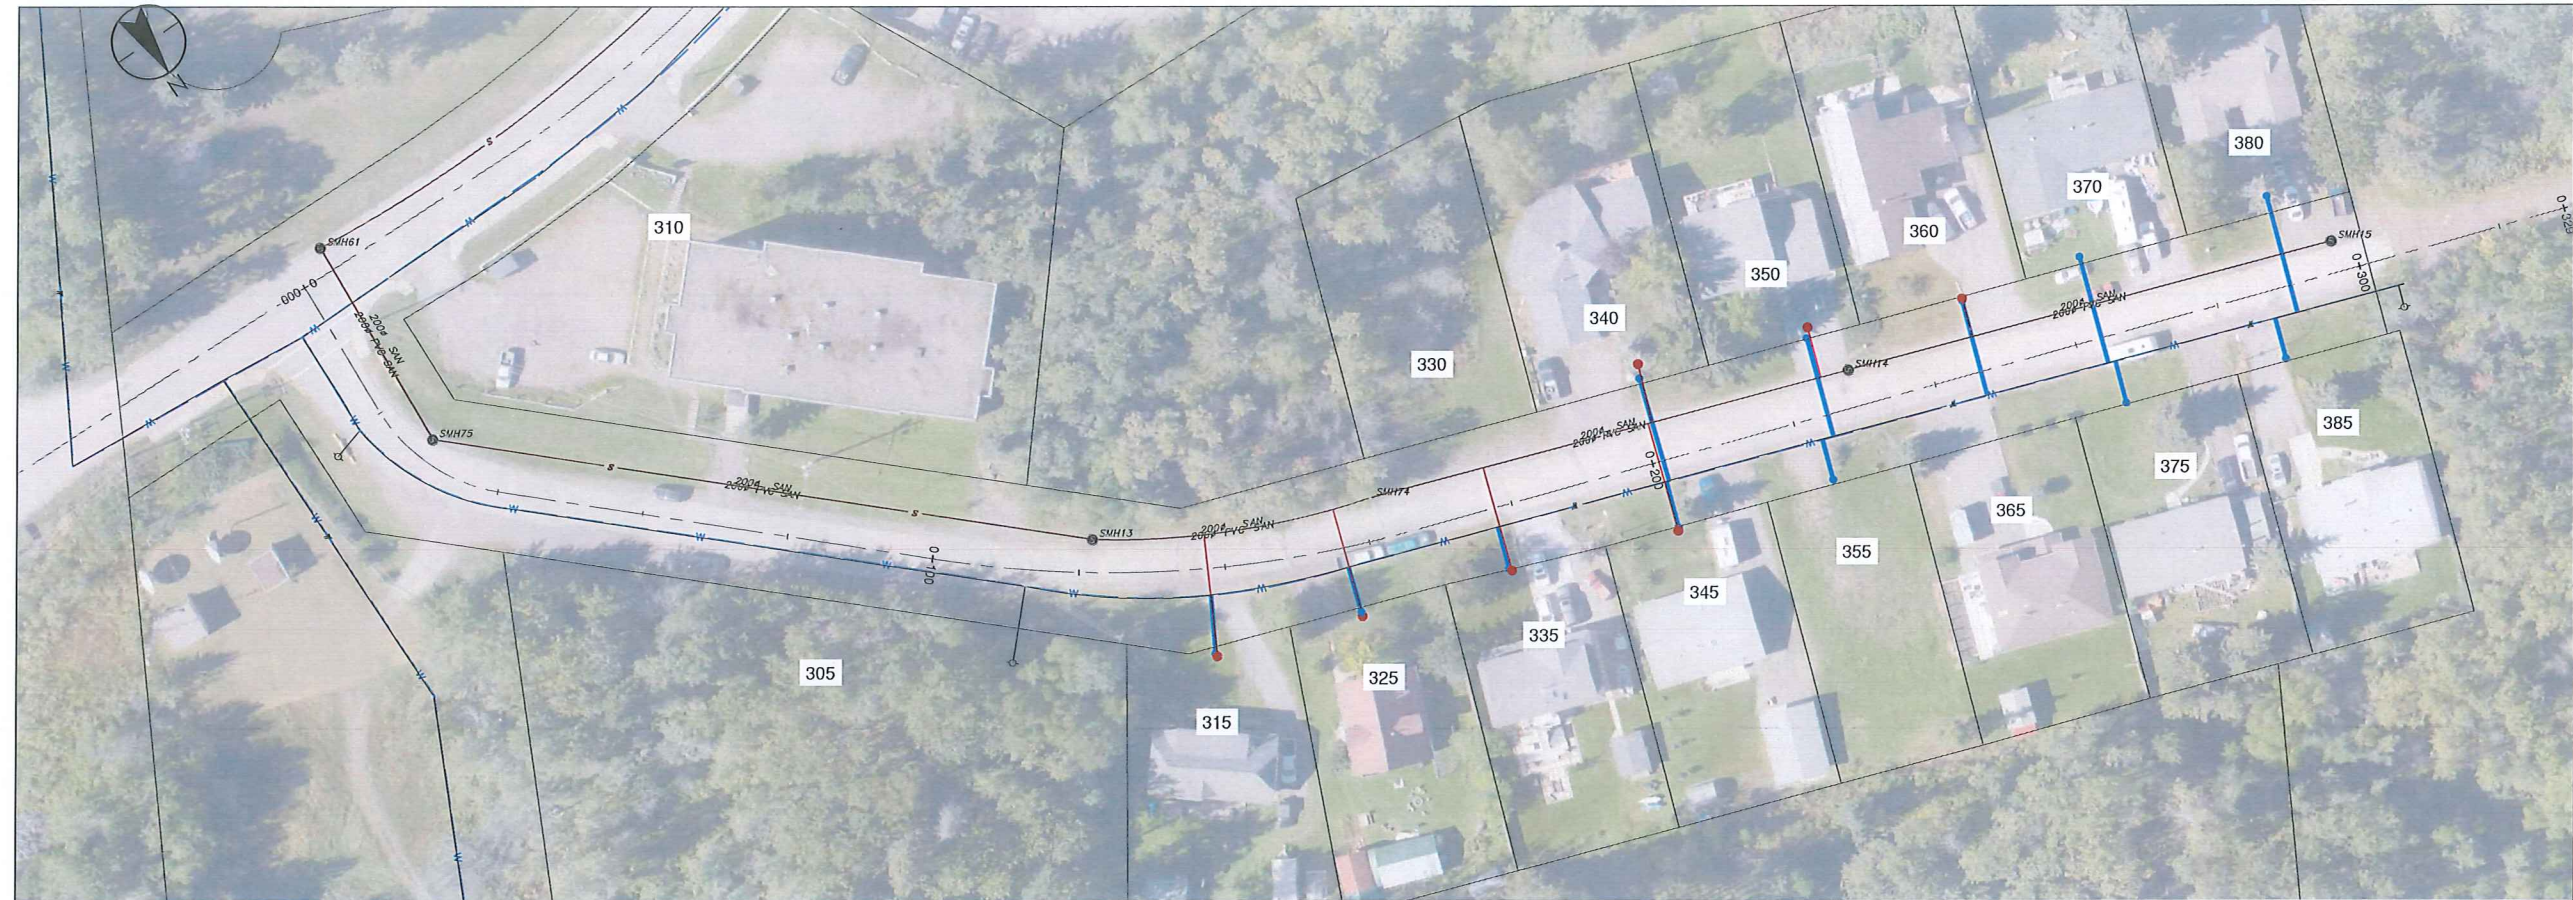

Stantec Consulting Ltd.
202 - 107 Main Street
Whitehorse, Yukon Y1A 2A7
Tel: (867) 663-2400
www.stantec.com

Consultant

[illegible][illegible]

Permit/Seal

**PRELIMINARY
NOT FOR
CONSTRUCTION**

Not for permits, pricing or other official purposes. This document has not been completed or checked and is for general information or comment only.

Client/Project
DISTRICT OF FT. ST. JAMES

WATER DISTRIBUTION
SYSTEM RECORD
DRAWINGS

DISTRICT OF FT. ST. JAMES

Project No.: 115823082

File Name: PINE RIDGE RD

Scale: 1:500

<u>KS</u>	<u>KS</u>	<u>SB</u>	<u>2025-10-10</u>
Dwn.	Dsgn.	Chkd.	YYYY.MM.DD

Title
PINE RIDGE RD -
SERVICE
CONNECTION

Revision: 0 Sheet: 1 of 1

Drawing No.

C124

\\115823082\115823082_115823082_115823082.dwg
2025-10-10 3:45:13 PM



ORIGINAL SHEET - A11C2

D

C

B

A

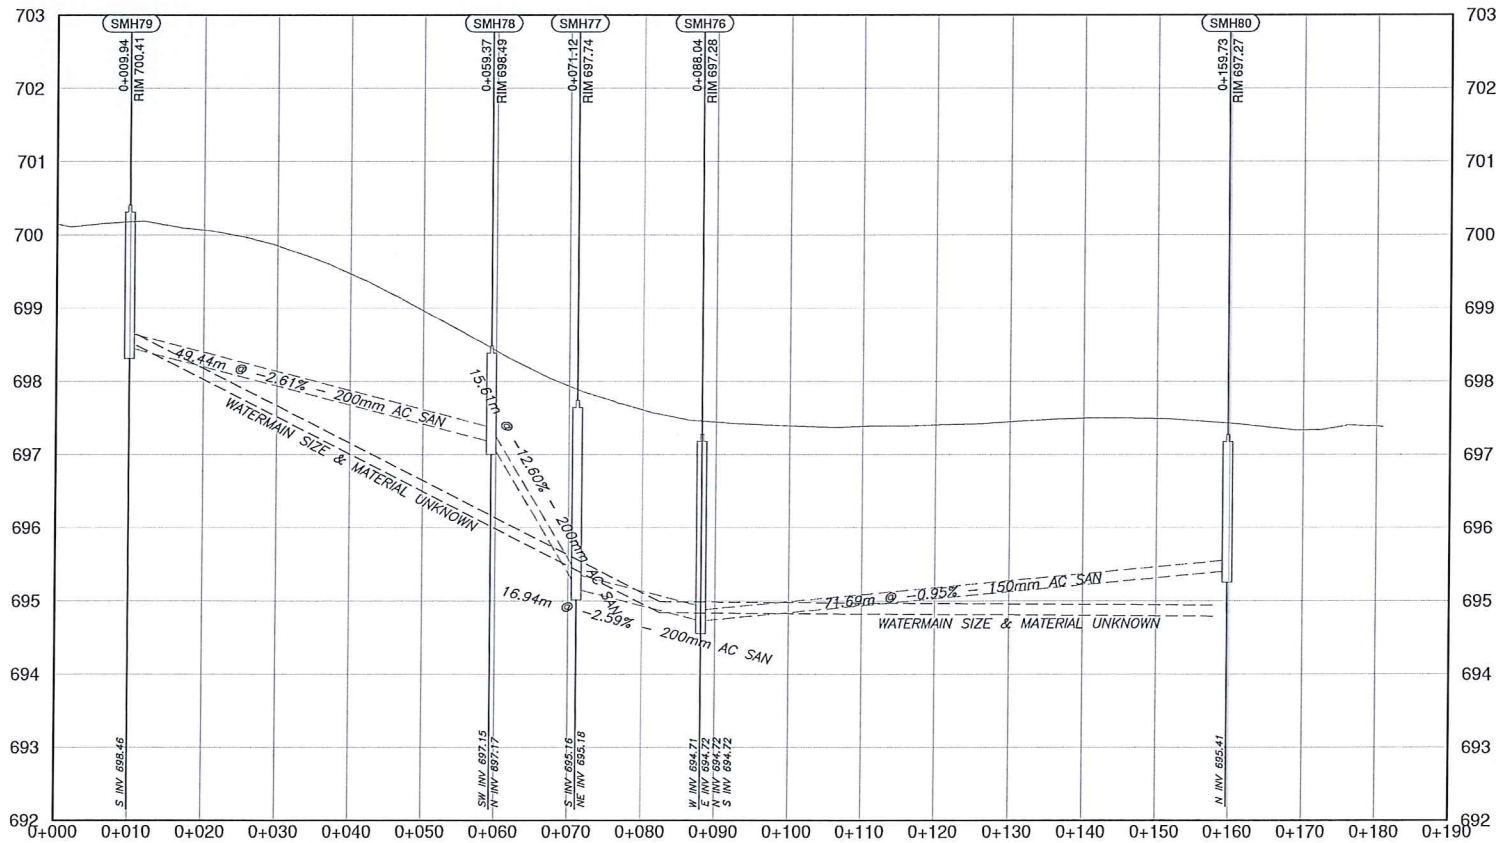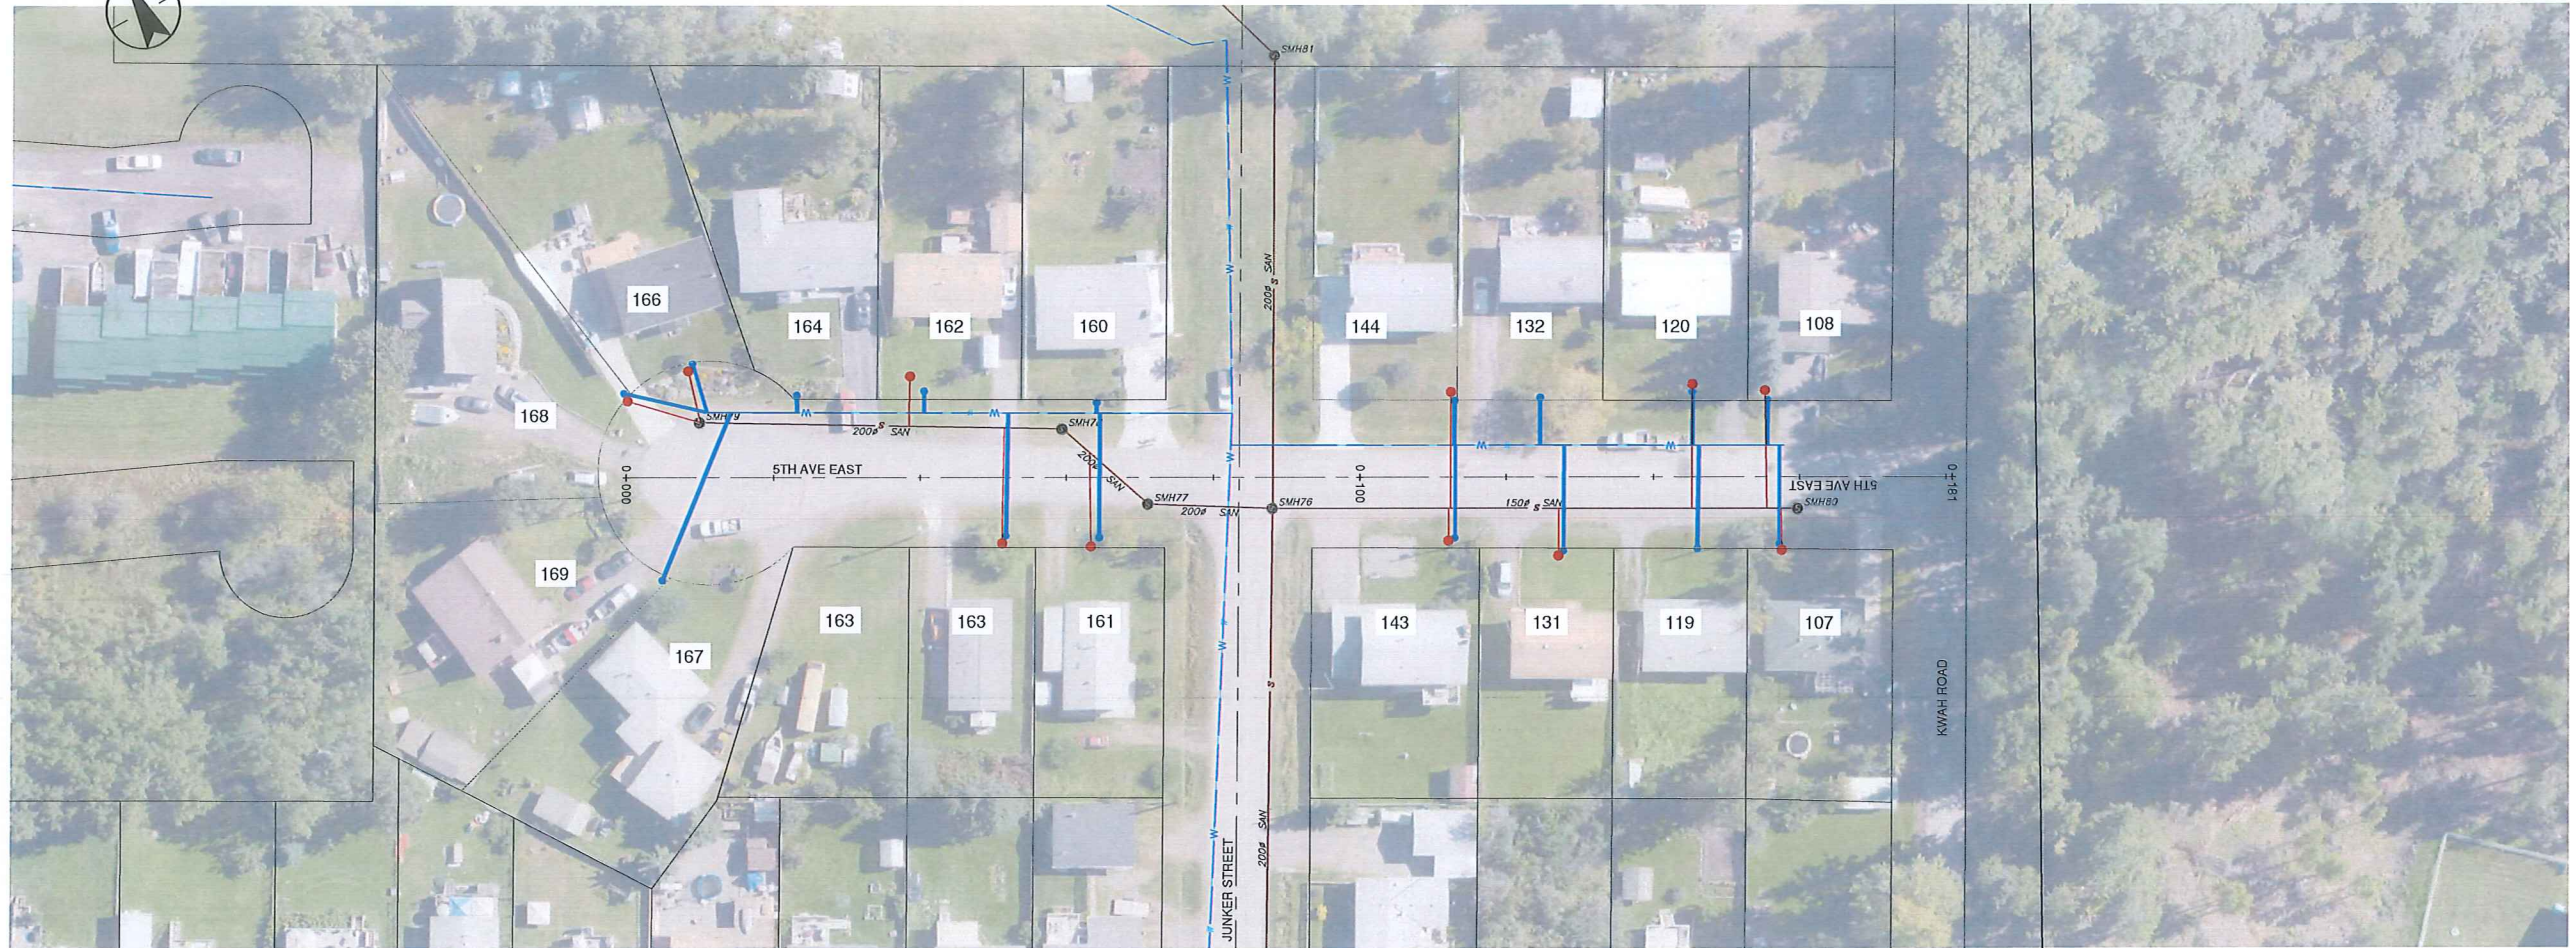

Stantec Consulting Ltd.
202 - 107 Main Street
Winnipeg, Manitoba R2S 2A7
Tel: (204) 463-2400
www.stantec.com

The Contractor shall verify and be responsible for all dimensions. DO NOT scale the drawing. Any errors or omissions shall be reported to Stantec within 10 days of the date of issuance of this drawing. Stantec shall not be responsible for any errors or omissions in any drawings or documents prepared by third parties.

Consultant

Revision	By	Appd	YTY:AM:DD

FOR DISCUSSION	Issued

Permit/Seal

**PRELIMINARY
NOT FOR
CONSTRUCTION**

Not for permits, pricing or other official purposes. This document has not been completed or checked and is for general information or comment only.

Client/Project
DISTRICT OF FT. ST. JAMES

WATER DISTRIBUTION
SYSTEM RECORD
DRAWINGS

DISTRICT OF FT. ST. JAMES

Project No.: 115823082

File Name: 5TH AVE EAST

Scale: 1:500

KS	KS	SB	2025-10-10
Dwn	Dgn	Chd	YTY:AM:DD

Title
5TH AVE EAST -
SERVICE
CONNECTION

Revision: 0 Sheet: - of -

Drawing No.

C122

u:\115823082\4th Ave East\4th Ave East.dwg
2025.10.10 2:37:42 PM



ORIGINAL SHEET - AXC1D

D

C

B

A

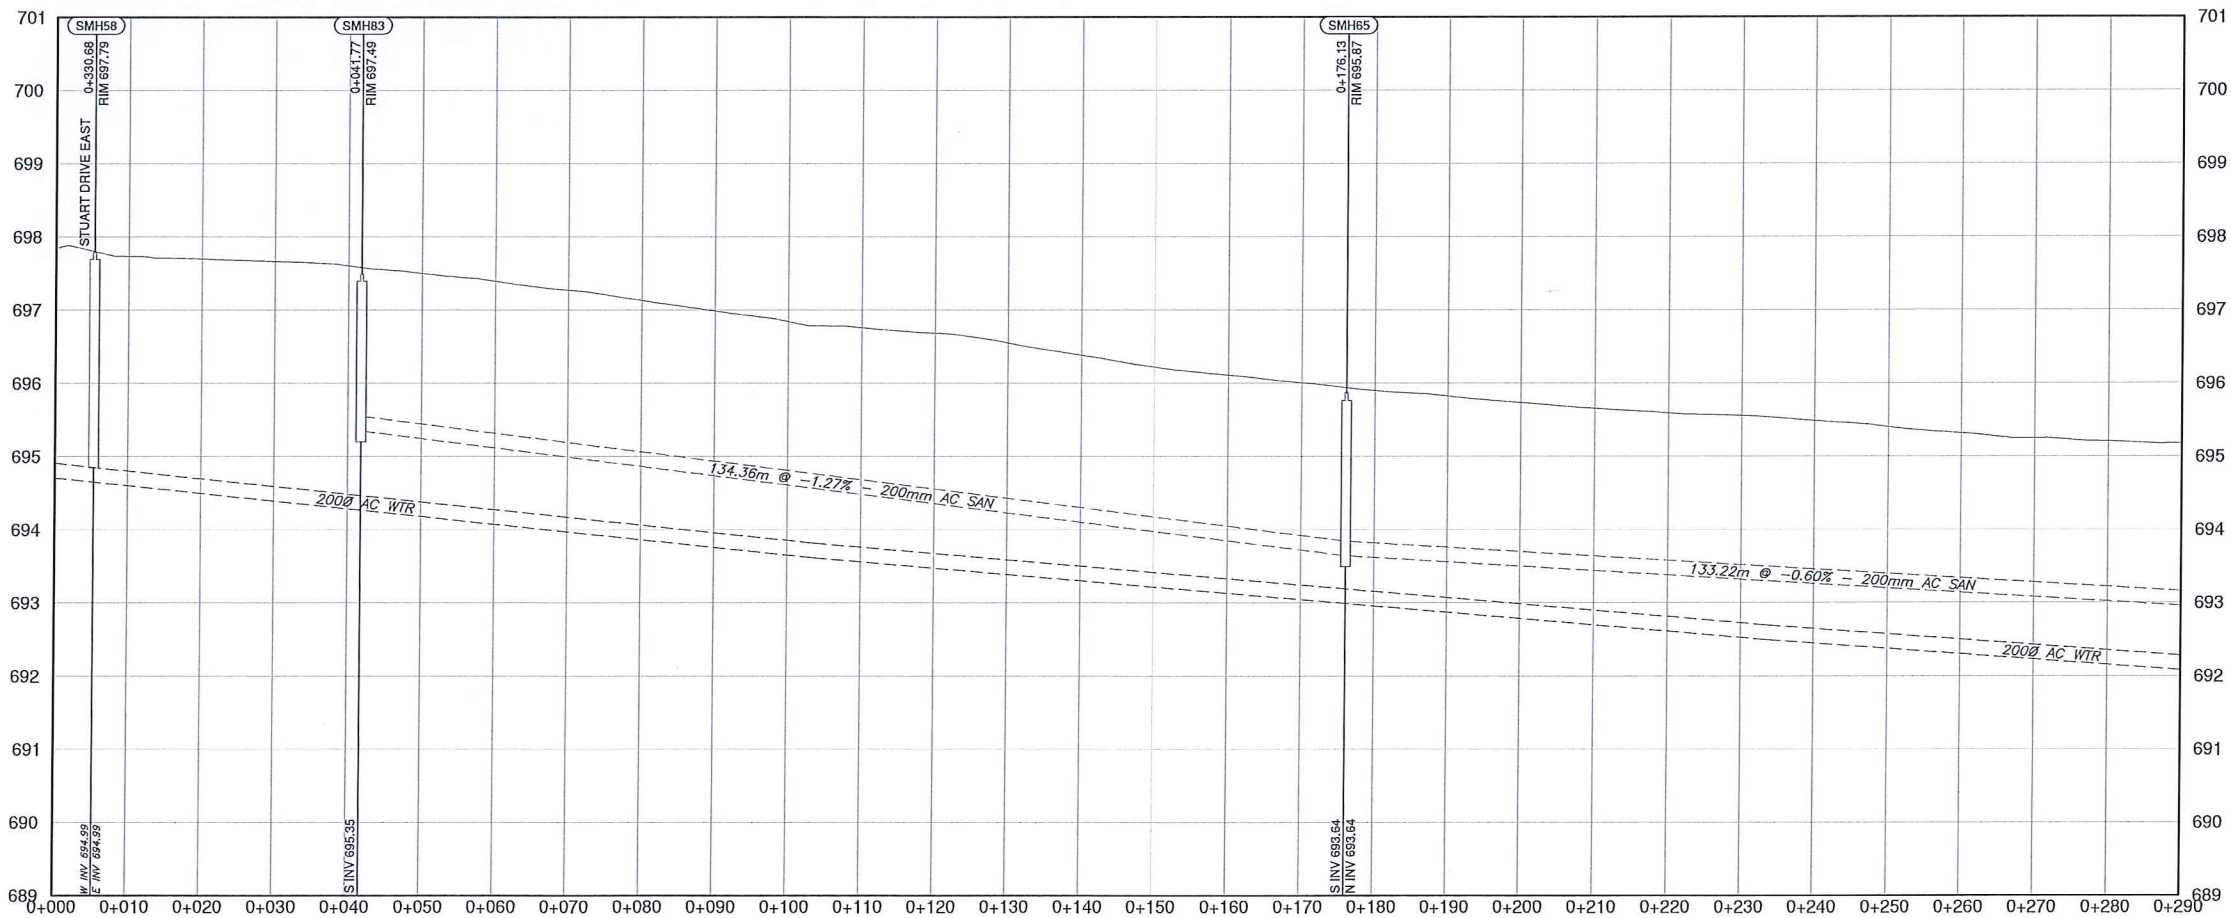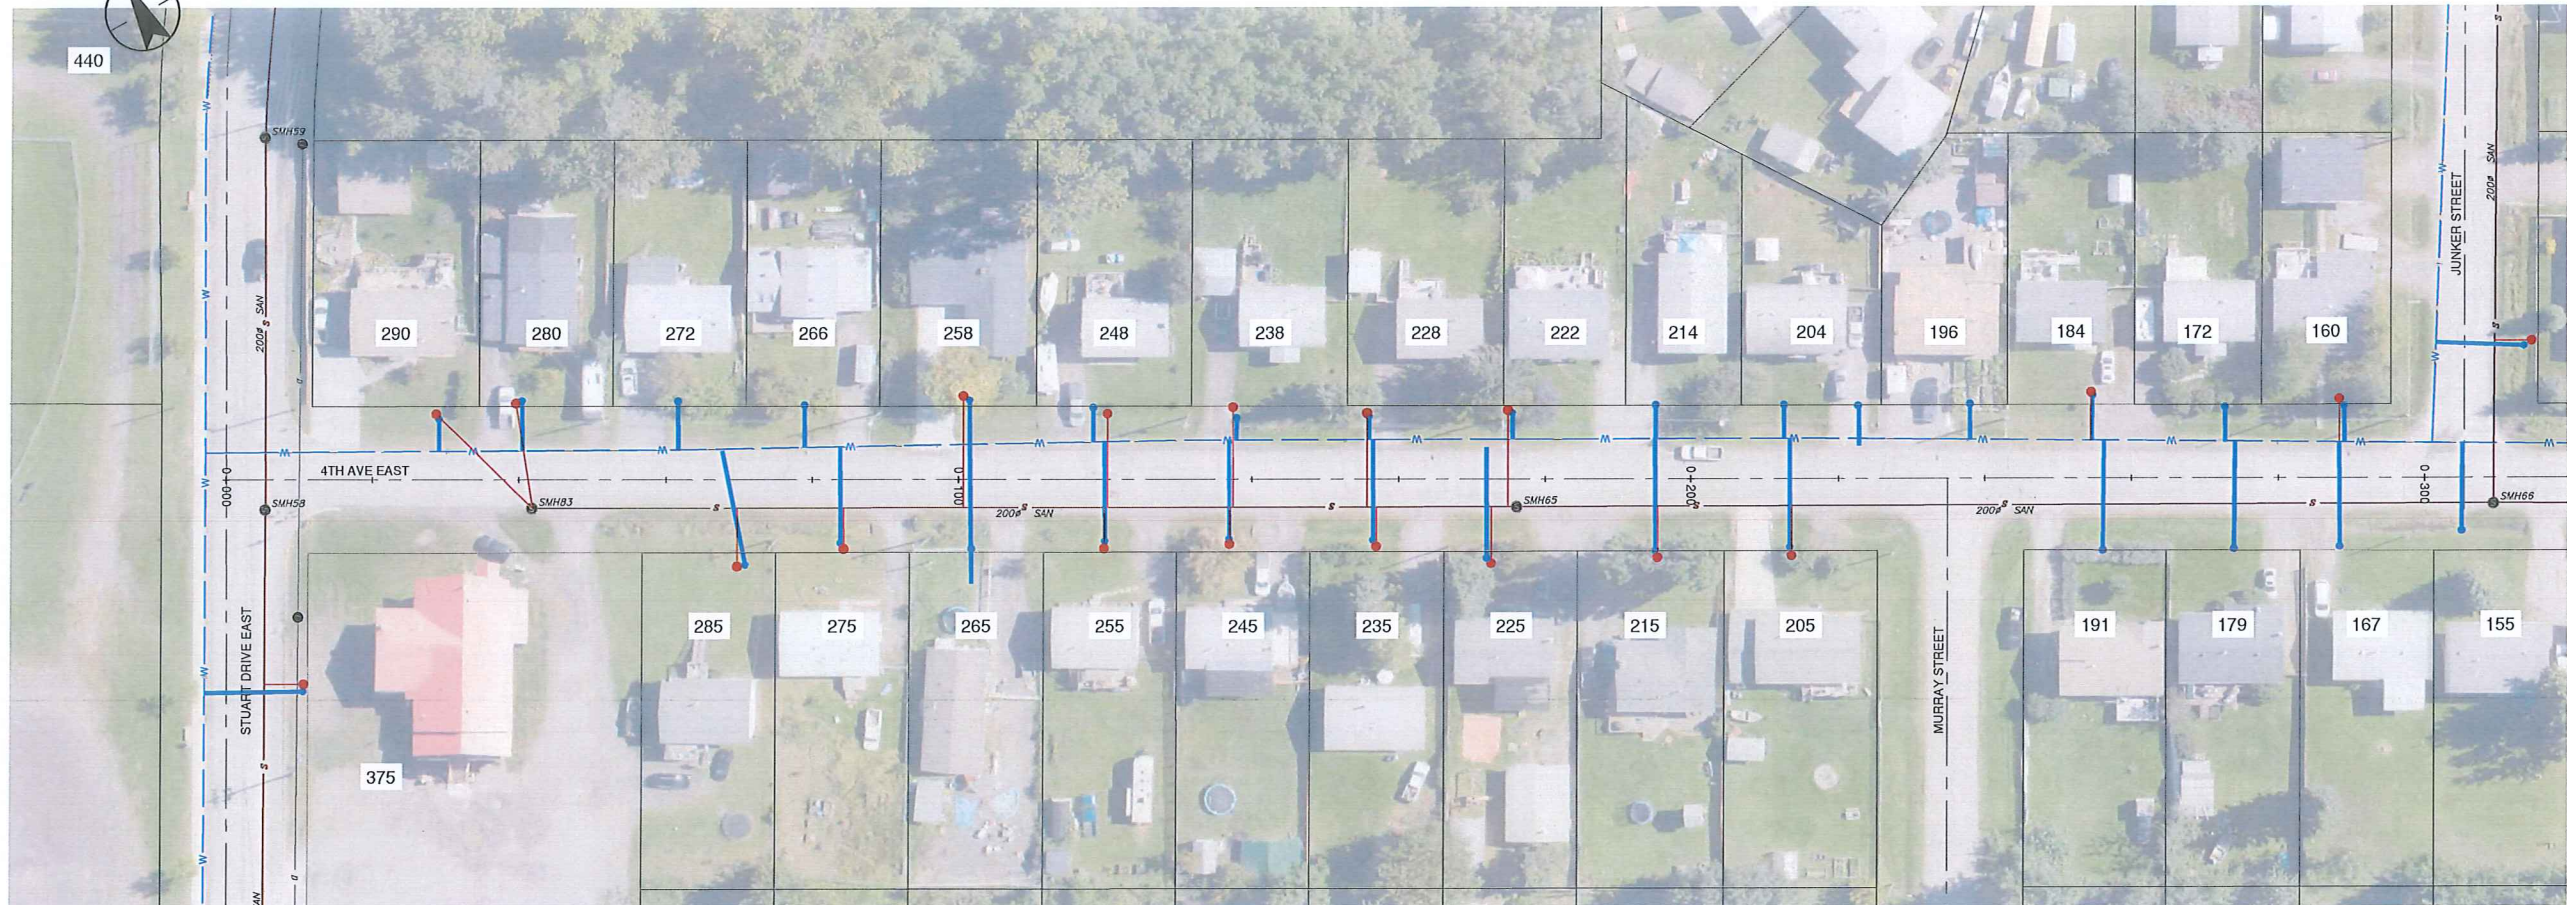

Stantec Consulting Ltd.
1000 West Street
Windsor, Ontario N9A 2A7
Tel: (817) 663-2400
www.stantec.com

Consultant

Revision	By	Appd	YTYJAWDD

For Discussion	Issued	By	Appd	YTYJAWDD

Permit/Seal

**PRELIMINARY
NOT FOR
CONSTRUCTION**

Not for permits, pricing or other official purposes. This document has not been completed or checked and is for general information or comment only.

Client/Project
DISTRICT OF FT. ST. JAMES

WATER DISTRIBUTION
SYSTEM RECORD
DRAWINGS

DISTRICT OF FT. ST. JAMES

Project No.: 115823082

File Name: 4TH AVE EAST

Scale: 1:500

Dwn.	Dgn.	Chkd.	YTYJAWDD
KS	KS	SB	2025-10-10

Title

4TH AVE EAST -
SERVICE
CONNECTION

Revision:0 Sheet: - of -

Drawing No.

C120